


Sewer long section Line A

NOTES:

ALL GRADE CHANGES SHOWN TO BE BY VERTICAL CURVES OF LENGTH AT LEAST 3m.

PIPELINE CROSSING WORKS BETWEEN CHAINAGE 125m and 140m TO BE NOTIFIED TO WELLINGTON WATER AT LEAST 3 DAYS BEFORE START.

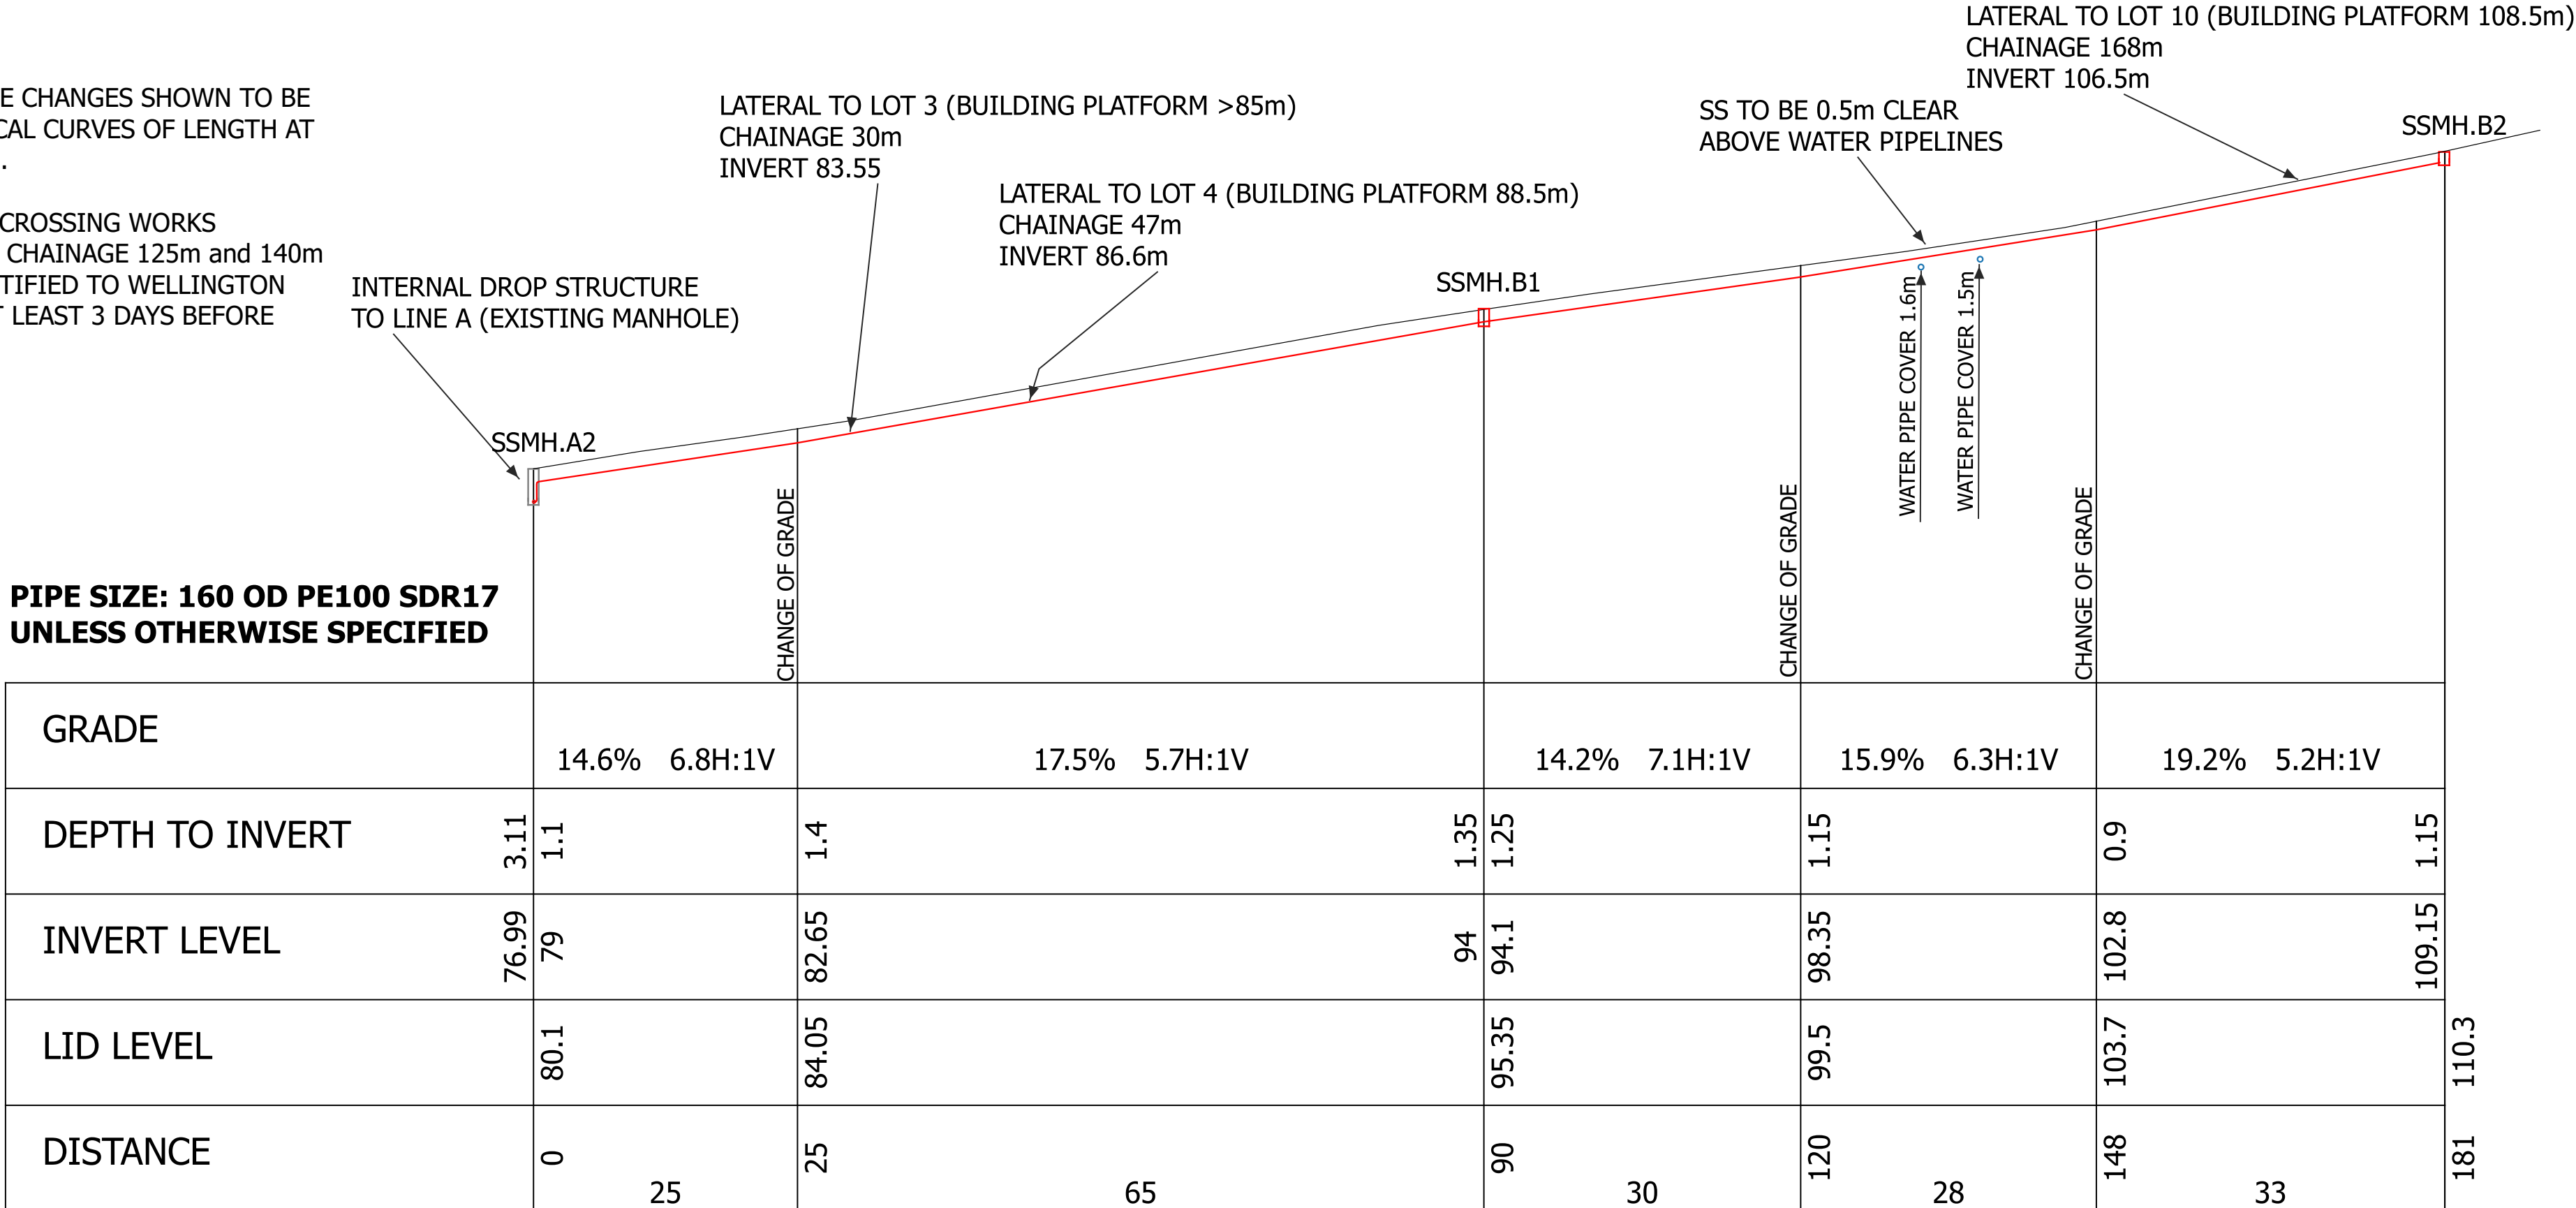

Sewer long section Line B



| |
|--|
| REVISION 0: ===== |
| ORIGINAL PLAN DATED 2016-09-16 APPROVED FOR PURPOSES OF EARLY INSTALLATION BY DIRECTIONAL DRILLING OF SEWER UNDER GWRC WATER PIPELINES. |
| REVISION 1 ===== |
| REDRAWN TO REFLECT SUCCESSFUL INSTALLATION OF SSMH.A2 AND SSMH.A3 AND SEWER COMPLETED UNDER GWRC PIPELINES. OTHER CHANGES INCLUDE CORRECTION FOR AS BUILT ROW EARTHWORKS AND CHANGES SUGGESTED BY ENGINEER. |

Progeni Ltd

68 Exploration Way, Porirua 5024
Ph 64 022 0819600

| | | | | | |
|----------|---------------------|------------|------------------|------------|---------------------------|
| Client: | Progeni Ltd | Fieldwork: | - | Scale: | 1:500 at A1; 1:1000 at A3 |
| Project: | Exploration Heights | Designed: | Harpham(Progeni) | ID: | P1.ENG012A Rev: 1 |
| Title: | Sewer long sections | Drawn: | Harpham(Progeni) | Issued by: | David Harpham |
| | | Checked: | O'CALLAGHAN | Date: | 2017-10-30 |