


- DRAINAGE ASBUILT NOTES:**
- UNLESS SHOWN OTHERWISE:
- ALL CO-ORDINATES ARE IN TERMS OF NZGD 2000 - WELLINGTON CIRCUIT
 - LEVELS ARE IN TERMS OF WELLINGTON VERTICAL DATUM 1953
 - ORIGIN OF LEVELS: SP 1 DP 478324 R.L 73.15m.
SOURCE: NZVD16 DERIVED.
 - ALL NEW SS MAINS ARE 160 OD PE100 SDR17
 - ALL NEW SW PIPES ARE 300 DN CIVILBOSS SN 16 UNLESS OTHERWISE SHOWN
 - ALL NEW LATERALS ARE DN100 uPVC SN16
 - MANHOLES DETAILS AS SHOWN ON ASBUILT TABLES
 - REFER TO 01-AB600 SERIES DRAWINGS FOR WATER SUPPLY.



SEWER COORDINATE TABLE									
LINE	PIT	DETAIL	EASTING	NORTHING	LID	INVERT	DEPTH	CLASS	PIPE DIA
A	EXSSMH.A1	1050 MH	409753.26	819710.64	74.37	73.09	1.28	PE100 SDR17	160 OD
A	SSMH.A2	1200 MH	409756.78	819675.64	80.11	76.91	3.20	PE100 SDR17	160 OD
A	SSMH.A3	1050 MH	409752.69	819631.28	80.57	78.28	2.29	PE100 SDR17	160 OD
A	SSMH.A4	1050 MH	409747.70	819574.68	80.87	79.52	1.35	PE100 SDR17	160 OD
B	SSMH.B1	1050 MH	409825.27	819615.49	95.58	94.12	1.46	PE100 SDR17	160 OD
B	SSMH.B2	1050 MH	409851.55	819526.38	110.34	108.96	1.38	PE100 SDR17	160 OD
-	SSL2	LATERAL	409758.98	819696.90	-	-	-	uPVC SN16	110 OD
-	SSL3	LATERAL	409801.45	819662.21	-	-	-	uPVC SN16	110 OD
-	SSL4	LATERAL	409798.44	819650.68	-	-	-	uPVC SN16	110 OD
-	SSL5	LATERAL	409763.89	819632.20	-	-	-	uPVC SN16	110 OD
-	SSL6	LATERAL	409754.94	819604.62	-	-	-	uPVC SN16	110 OD
-	SSL7	LATERAL	409754.40	819569.33	-	-	-	uPVC SN16	110 OD
-	SSL8	LATERAL	409746.10	819558.72	-	-	-	uPVC SN16	110 OD
-	SSL9	LATERAL	409836.21	819502.44	-	113.5	-	uPVC SN16	110 OD
-	SSL10	LATERAL	409849.03	819551.74	-	-	-	uPVC SN16	110 OD

LEGEND

— SW —	— SW —	EXISTING SW MAIN
— S —	— S —	EXISTING SS MAIN
— —	— —	NEW SW MAIN
— —	— —	NEW SW LATERAL
— —	— —	NEW SS MAIN
— —	— —	NEW SS LATERAL
— —	— —	NEW SUMP
— —	— —	NEW HEADWALL
— —	— —	NEW WATERSTOP

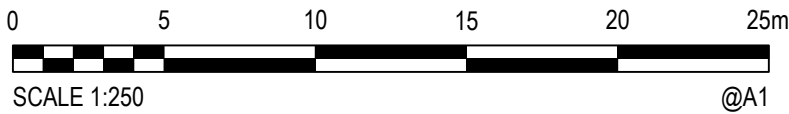

Drawn		Date	
TN		JUNE 2019	
Checked		Date	
EDD		16/07/2019	
Designed		Date	
Verified		Date	
Approved		Date	
1		16/07/2019	
FOR INFORMATION		EDD	
Issue		Date	
Description		Des.	
		Ver.	
		App.	
		Date	
		16/07/2019	

© Orogen Limited - All Rights Reserved.
This document is produced by Orogen Limited for the sole use and benefit of the original recipient. Orogen Limited does not and shall not assume any responsibility or liability whatsoever for any use of this document by a third party



Client		PROGENI LIMITED	
Project		68 EXPLORATION WAY WHITBY PORIRUA	
Status		AS CONSTRUCTED	
Title		DRAINAGE ASBUILT PLAN SHEET 2 OF 3	
Datum		Council Ref.	Scale
WGTN2000		RC6601	1:250m
Drawing Number		W16018-AB512	
		Original Size	
		A1	
		Issue	
		1	

DATE: 16 July 2019 4:44 PM
Reference Files: \$2

Drawing File: P:\W16018\cad\W16018-01-AB500-DRAINAGE-01.dwg

DO NOT SCALE DRAWING 0 1 2 3 4 5 6 7 8 9 10 11 12 13 14 15 16 17 18 19 20