


WATER ASBUILT NOTES:

UNLESS SHOWN OTHERWISE:

1. ALL CO-ORDINATES ARE IN TERMS OF NZGD 2000 - WELLINGTON CIRCUIT
2. LEVELS ARE IN TERMS OF WELLINGTON VERTICAL DATUM 1953
3. ORIGIN OF LEVELS: SP 1 DP 478324 R.L 73.15m.
SOURCE: NZVD16 DERIVED
4. ALL SERVICE CONNECTIONS ARE 25 OD PE80b SDR11 TERMINATING IN A MANIFOLD BOX
5. EXISTING WATER DETAILS SOURCED FROM PCC GIS

1. ALL CO-ORDINATES ARE IN TERMS OF NZGD 2000 - WELLINGTON CIRCUIT
2. LEVELS ARE IN TERMS OF WELLINGTON VERTICAL DATUM 1953
3. ORIGIN OF LEVELS: SP 1 DP 478324 R.L 73.15m.
SOURCE: NZVD16 DERIVED
4. ALL SERVICE CONNECTIONS ARE 25 OD PE80b SDR11 TERMINATING IN A MANIFOLD BOX
5. EXISTING WATER DETAILS SOURCED FROM PCC GIS

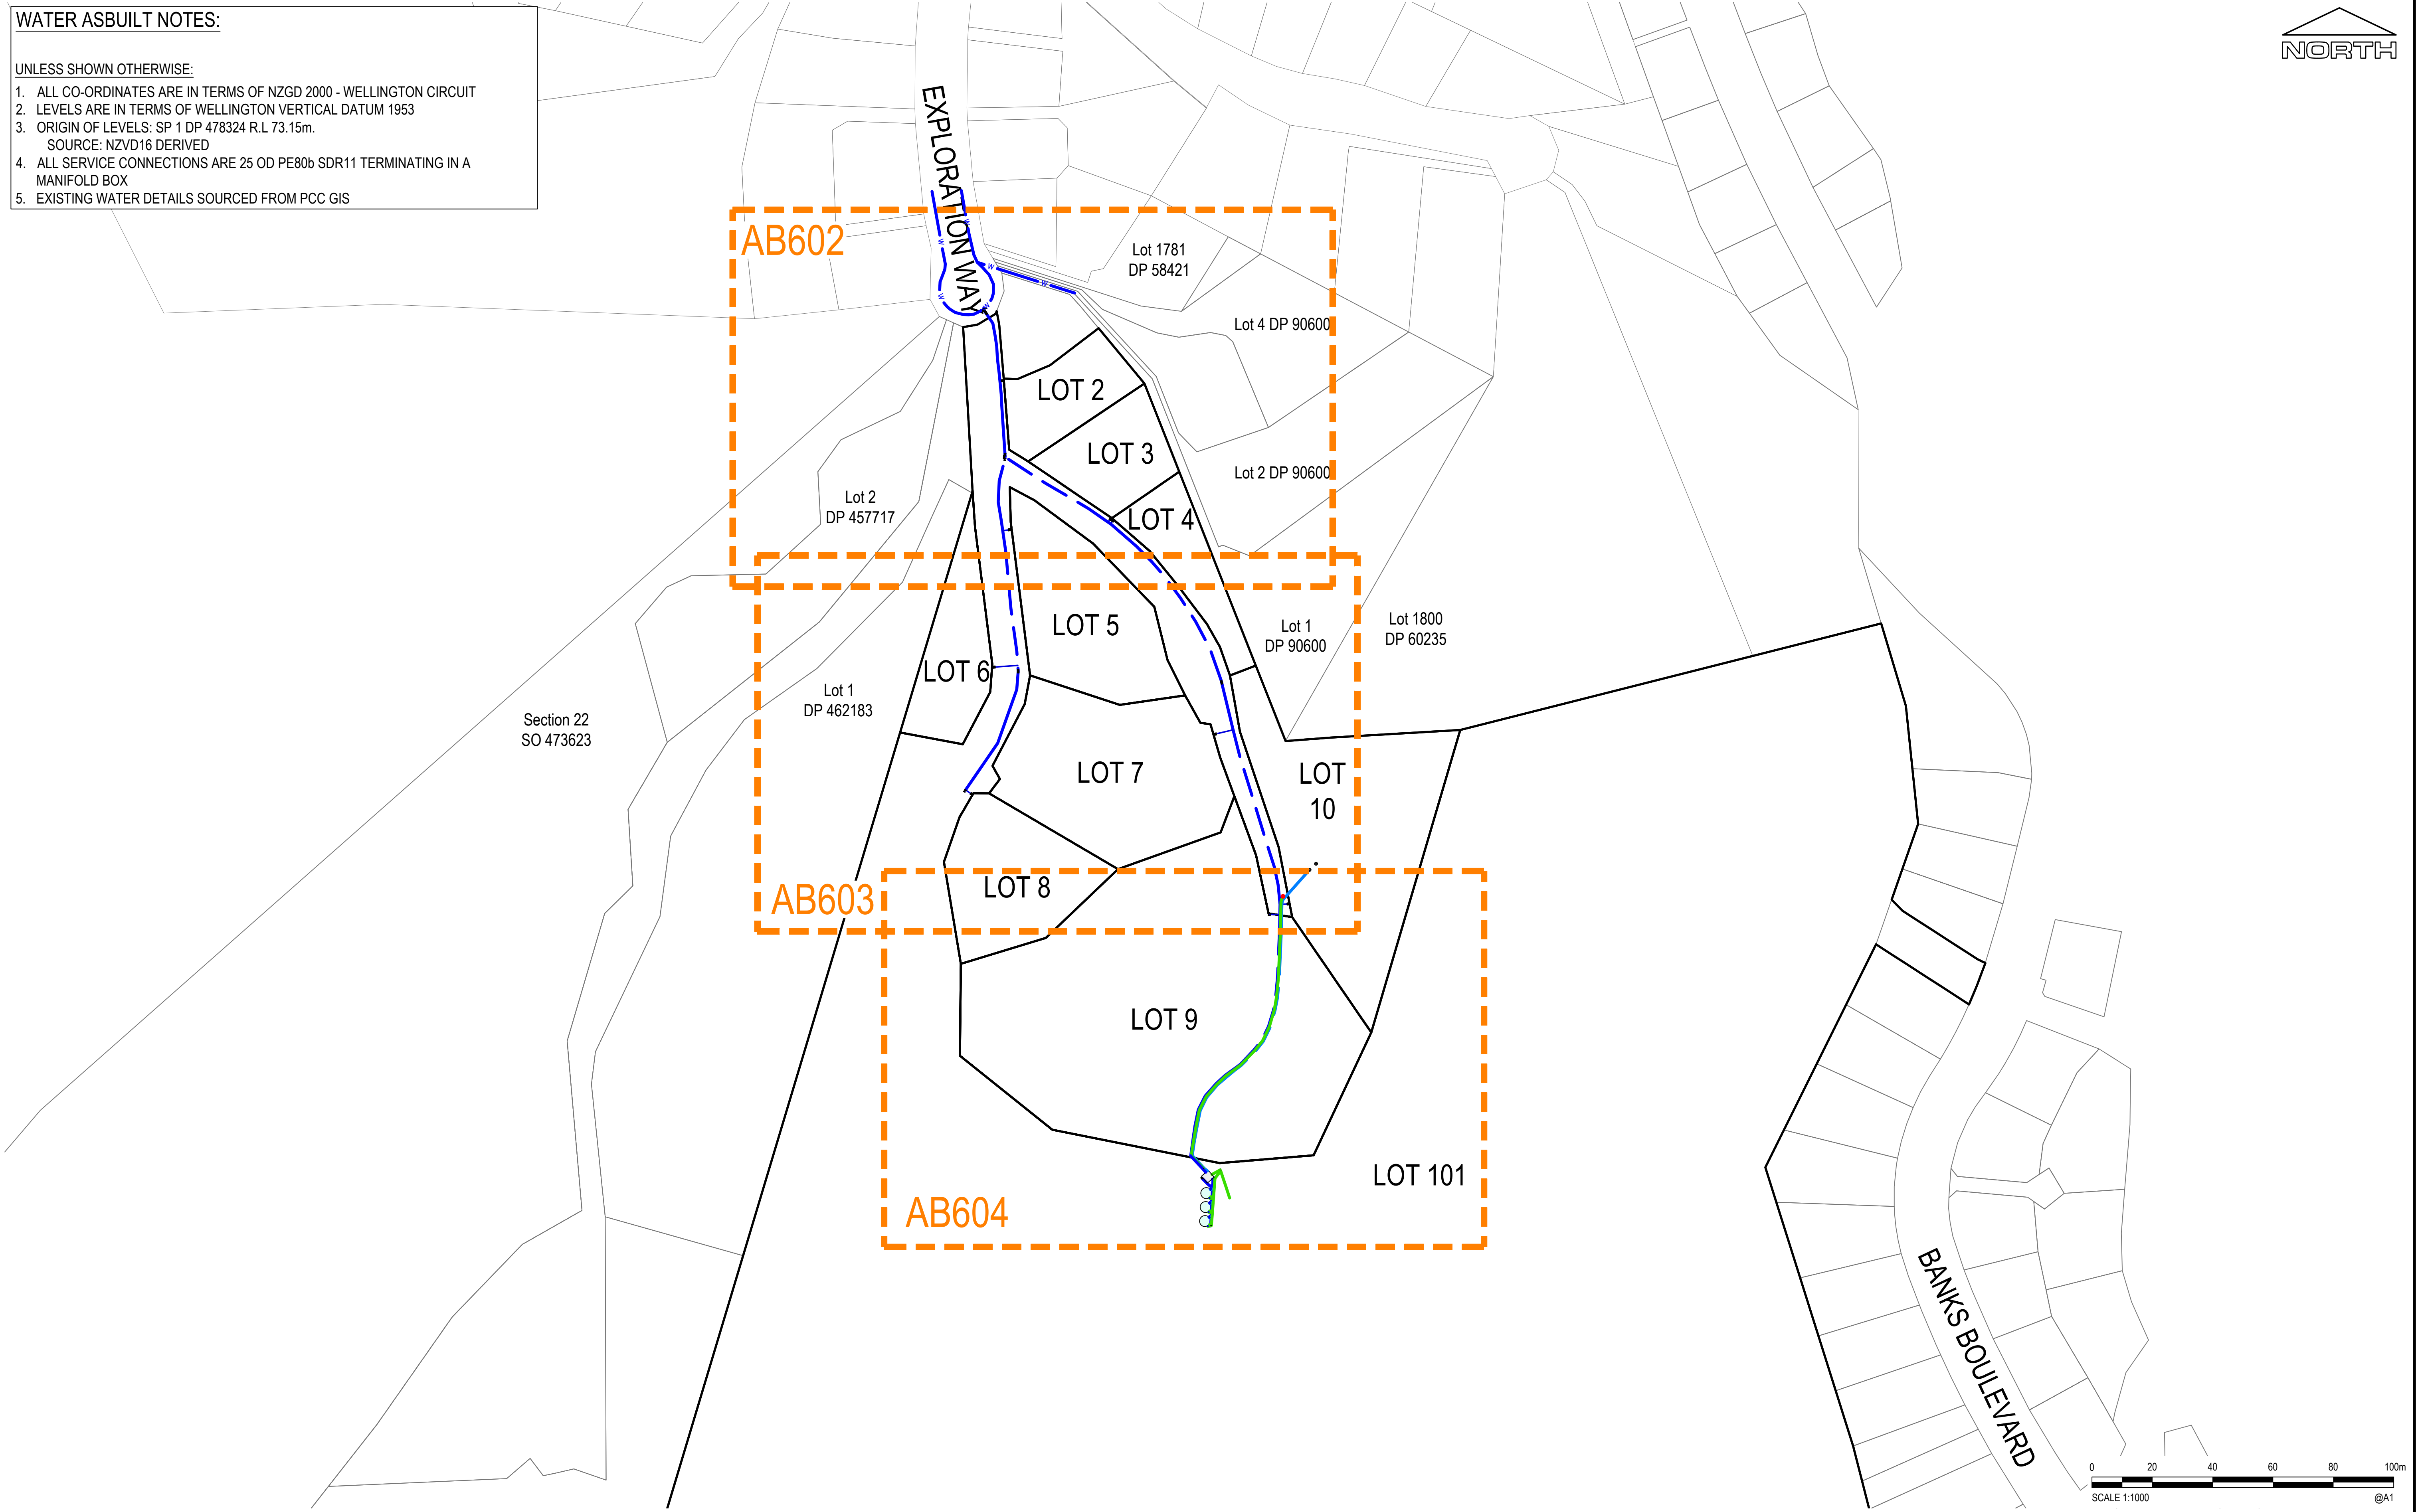

							Drawn	Date
							TN	JUNE 2019
							Checked	Date
							EDD	15/07/2019
							Designed	Date
							Verified	Date
							Approved	Date
1 Issue	15/07/2019 Date	FOR INFORMATION		EDD Des.		CBR Veri. App.	CBR	Date 15/07/2019
		Description						

© Orogen Limited - All Rights Reserved.
This document is produced by Orogen Limited for the sole use and benefit of the original recipient. Orogen Limited does not and shall not assume any responsibility or liability whatsoever for any use of this document by a third party



Client	PROGENI LIMITED					
Project	68 EXPLORATION WAY WHITBY PORIRUA		Title: WATER ASBUILT PLAN SHEET 1 OF 5 OVERALL SHEET			
Status	AS CONSTRUCTED		Date	Council Ref	Scale	Original Size
			WGTN2000	RC6601	1:1000m	A1
			Drawing Number		W16018-AB601	Issue 1