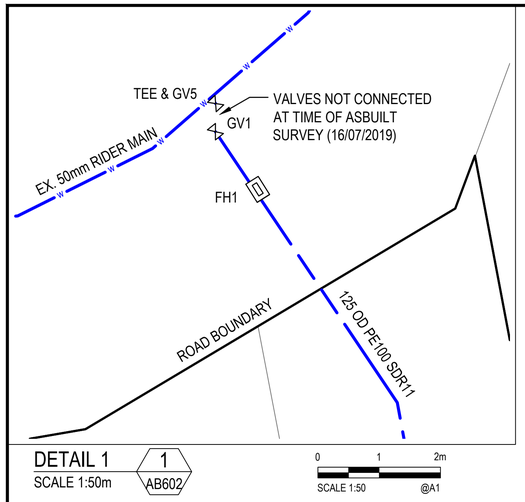

DETAIL 1 — 1 / AB602
SCALE 1:50m

0 1 2m
SCALE 1:50 @A1

WATER ASBUILT NOTES:

UNLESS SHOWN OTHERWISE:

1. ALL CO-ORDINATES ARE IN TERMS OF NZGD 2000 - WELLINGTON CIRCUIT
2. LEVELS ARE IN TERMS OF WELLINGTON VERTICAL DATUM 1953
3. ORIGIN OF LEVELS: SP 1 DP 478324 R.L 73.15m.
   SOURCE: NZVD16 DERIVED
4. ALL SERVICE CONNECTIONS ARE 25 OD PE80b SDR11 TERMINATING IN A MANIFOLD BOX
5. EXISTING WATER DETAILS SOURCED FROM PCC GIS

NORTH

Lot 1782 DP 58421
Lot 1783 DP 58421
Lot 1776 DP 58421
Lot 1781 DP 58421
Lot 5 DP 90600
Lot 4 DP 90600
Lot 1777 DP 58421
Lot 1 DP 478324
Section 22 SO 473623
Lot 3 DP 90600
Lot 2 DP 494925
Lot 2 DP 90600
Lot 2 DP 457717
Lot 1 DP 462183
DP 90600

EXPLORATION WAY
EX. 50mm RIDER MAIN
TEE & GV5
GV1
FH1
1 / AB602
125 OD PE100 SDR11
M2
LOT 2
LOT 3
LOT 4
LOT 101
T1
GV2
GV3
M3
M4
M5
450Ø GWRC BULK WATERMAIN
375Ø GWRC BULK WATERMAIN

LEGEND
- WATER LINE EXISTING
- BULK WATERMAIN EXISTING
- WATERMAIN
- FIRE HYDRANT
- WATER VALVE
- DEAD END CAP
- WATER MANIFOLD
- THRUST BLOCK

0 5 10 15 20 25m
SCALE 1:250 @A1

COORDINATE TABLES

WATER MANIFOLDS

NAME	EASTING	NORTHING	R.L
M2	409758.60	819697.30	76.6
M3	409794.38	819651.45	87.0
M4	409795.19	819650.91	87.1
M5	409760.89	819647.92	82.0
M6	409755.83	819602.37	80.2
M7	409829.16	819580.16	100.1
M8	409748.34	819560.29	82.0
M9	409847.01	819520.39	111.5
M10	409853.27	819523.86	110.5

FIRE HYDRANTS

NAME	EASTING	NORTHING	R.L
FH1	409753.15	819719.77	73.39
FH2	409763.80	819601.03	80.14
FH3	409831.22	819597.31	98.06

GATE VALVES

NAME	EASTING	NORTHING	R.L
GV1	409752.50	819720.77	73.33
GV2	409759.46	819672.41	80.83
GV3	409759.47	819671.57	80.97
GV4	409746.15	819561.34	82.48
GV5	409752.43	819721.21	73.3

TEES

NAME	EASTING	NORTHING	R.L
T1	409759.47	819672.00	-

Issue	Date	Description	Des.	Veri.	App.
1	15/07/2019	FOR INFORMATION	EDD		CBR

	Date
Drawn TN	JUNE 2019
Checked EDD	15/07/2019
Designed	
Verified	
Approved CBR	15/07/2019

© Orogen Limited - All Rights Reserved.
This document is produced by Orogen Limited for the sole use and benefit of the original recipient. Orogen Limited does not and shall not assume any responsibility or liability whatsoever for any use of this document by a third party

orogen
LAND · CIVIL · SPATIAL
Unit 1a - 10 Surrey Street, Tawa
PO Box 56051 - Tawa - Wellington 5249

Client: PROGENI LIMITED
Project: 68 EXPLORATION WAY, WHITBY, PORIRUA
Title: WATER ASBUILT PLAN SHEET 2 OF 5
Status: AS CONSTRUCTED
Datum: WGTN2000 | Council Ref: RC6601 | Scale: 1:250m | Original Size: A1
Drawing Number: W16018-AB602 | Issue: 1

DO NOT SCALE DRAWING 0 1 2 3 4 5 6 7 8 9 10 11 12 13 14 15 16 17 18 19 20

DATE: 16 July 2019 12:41 PM
Reference Files: $?
Drawing File: P:\W16018\cad\W16018-01-AB600-WATER-01.dwg