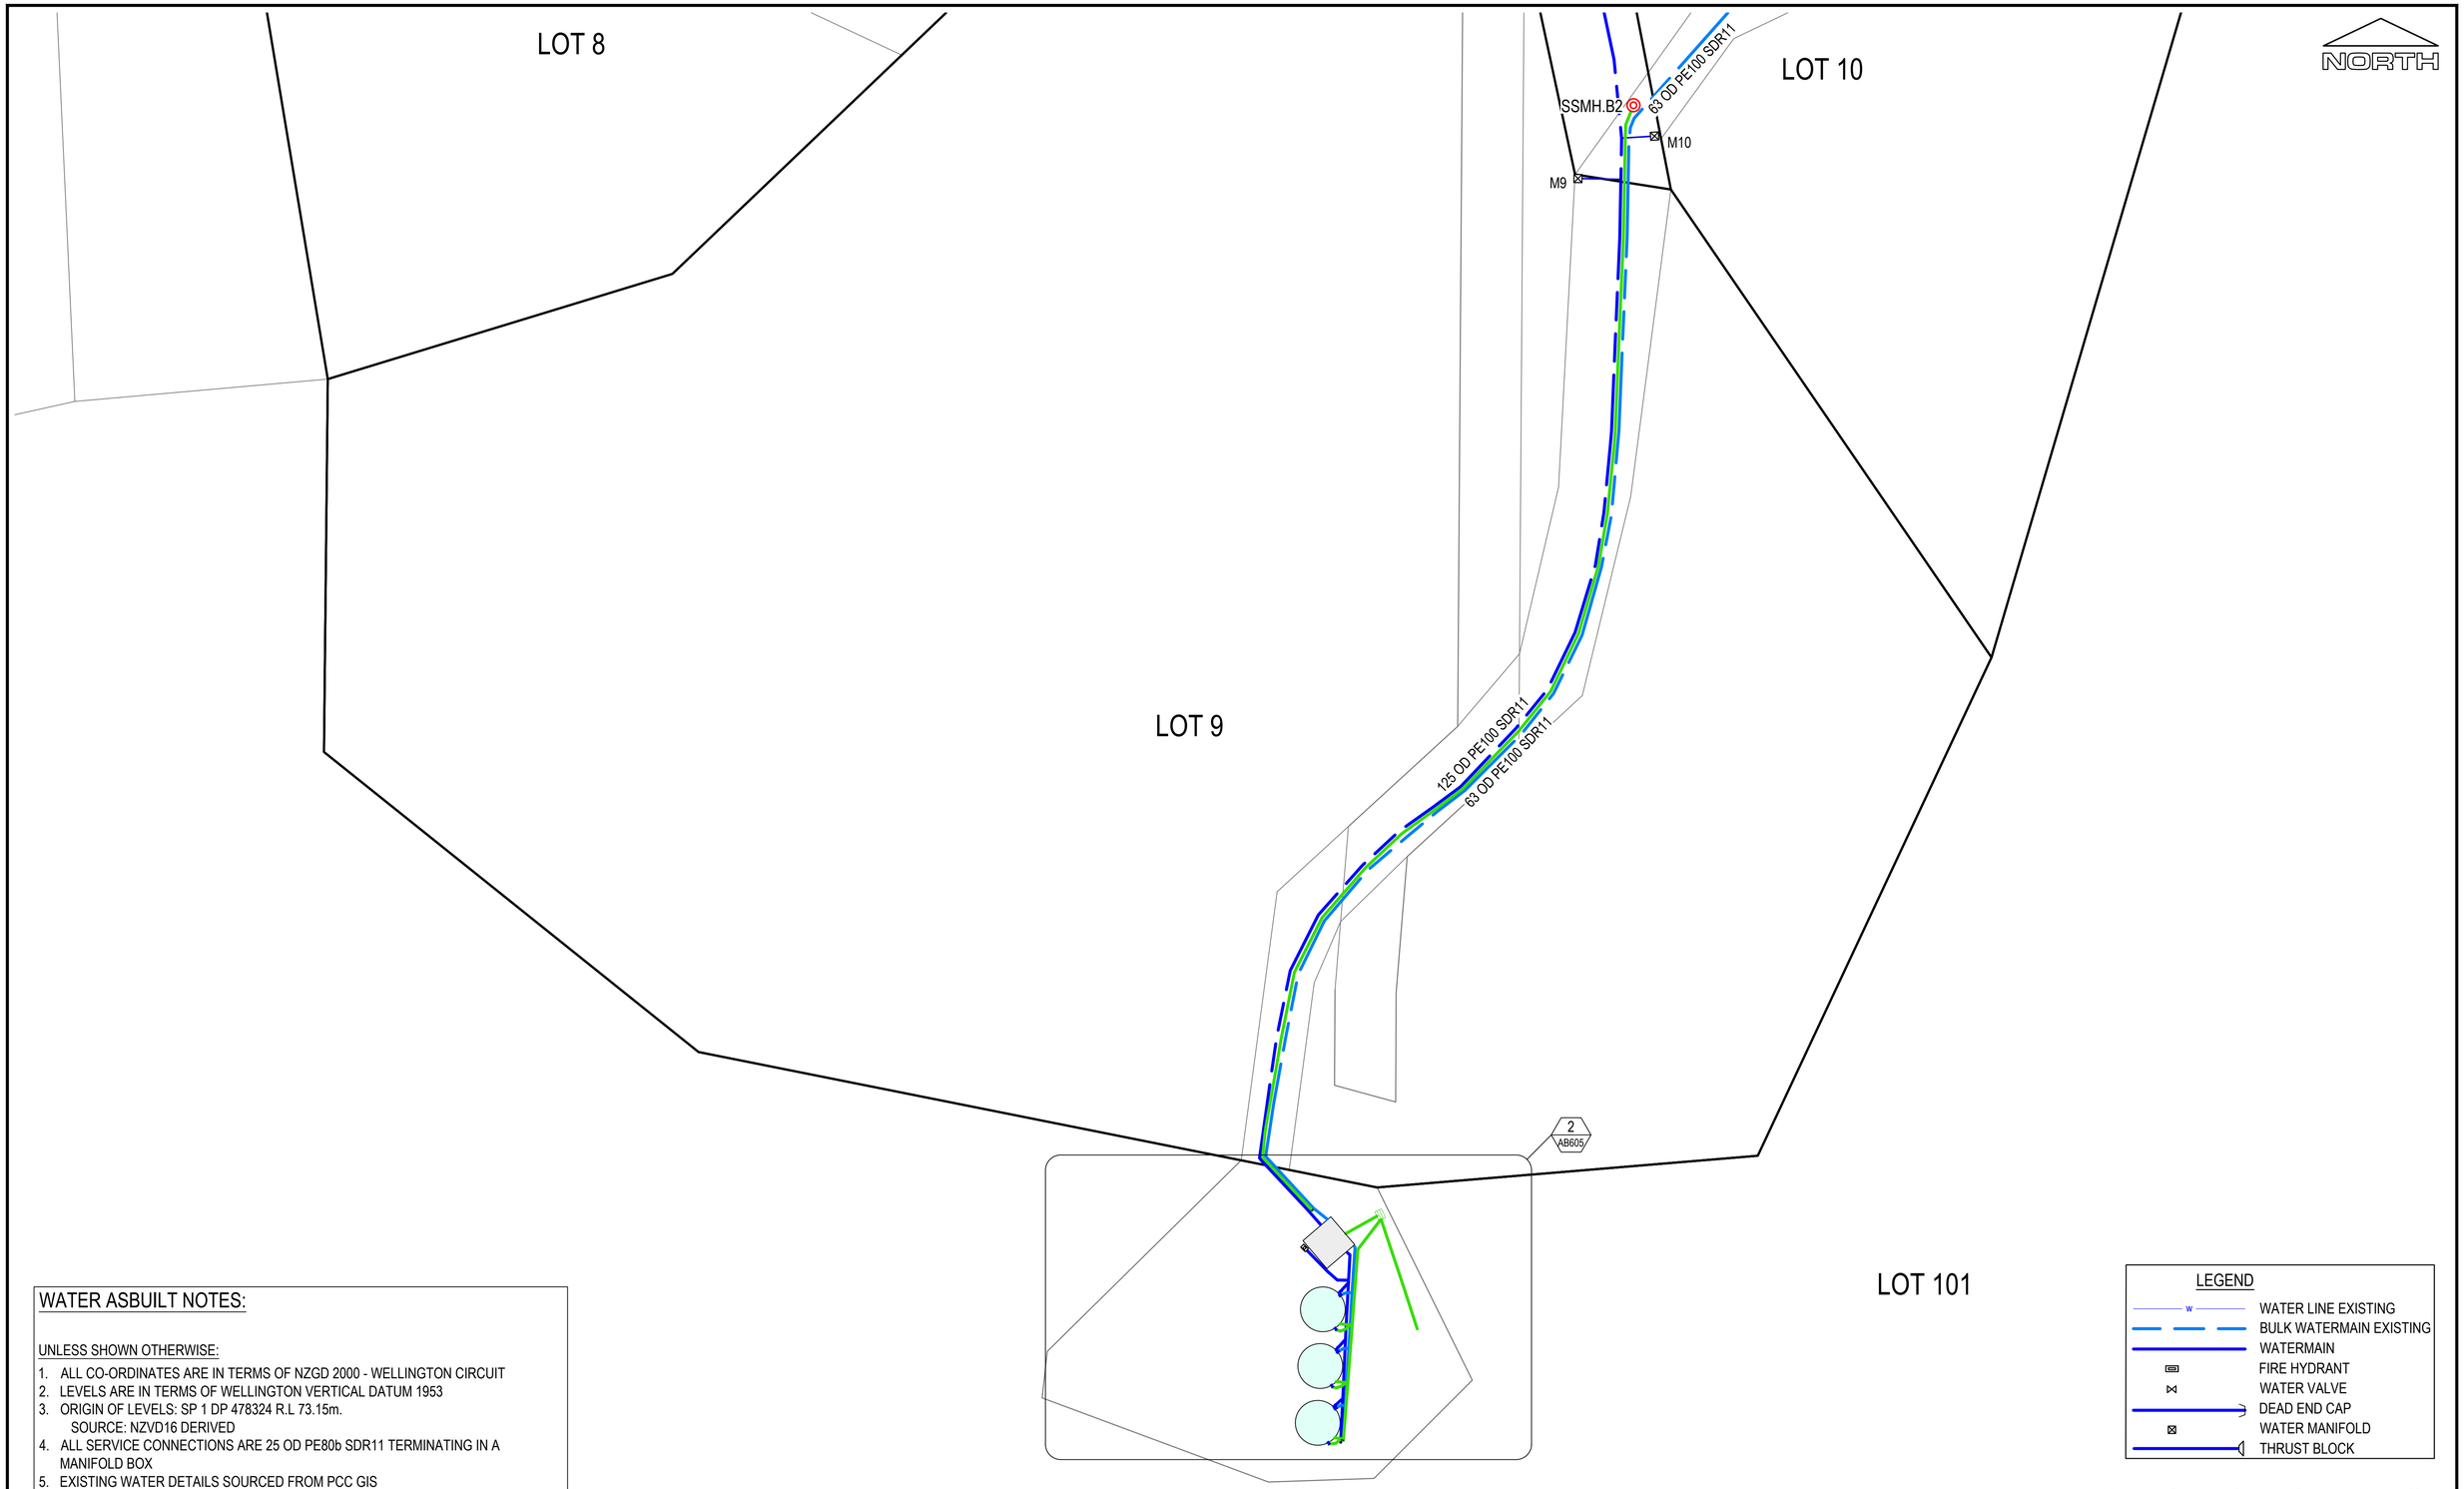

WATER ASBUILT NOTES:

UNLESS SHOWN OTHERWISE:

1. ALL CO-ORDINATES ARE IN TERMS OF NZGD 2000 - WELLINGTON CIRCUIT
2. LEVELS ARE IN TERMS OF WELLINGTON VERTICAL DATUM 1953
3. ORIGIN OF LEVELS: SP 1 DP 478324 R.L 73.15m.
   SOURCE: NZVD16 DERIVED
4. ALL SERVICE CONNECTIONS ARE 25 OD PE80b SDR11 TERMINATING IN A MANIFOLD BOX
5. EXISTING WATER DETAILS SOURCED FROM PCC GIS

LEGEND

- WATER LINE EXISTING
- BULK WATERMAIN EXISTING
- WATERMAIN
- FIRE HYDRANT
- WATER VALVE
- DEAD END CAP
- WATER MANIFOLD
- THRUST BLOCK

0 5 10 15 20 25m
SCALE 1:250 @A1

Issue	Date	Description	Des.	Veri.	App.
1	15/07/2019	FOR INFORMATION	EDD		CBR

Drawn TN Date JUNE 2019
Checked EDD Date 15/07/2019
Designed Date
Verified Date
Approved CBR Date 15/07/2019

© Orogen Limited - All Rights Reserved.
This document is produced by Orogen Limited for the sole use and benefit of the original recipient. Orogen Limited does not and shall not assume any responsibility or liability whatsoever for any use of this document by a third party

orogen
LAND • CIVIL • SPATIAL
Unit 1a - 10 Surrey Street, Tawa
PO Box 56051 - Tawa - Wellington 5249

Client: PROGENI LIMITED
Project: 68 EXPLORATION WAY, WHITBY, PORIRUA
Title: WATER ASBUILT PLAN SHEET 4 OF 5
Status: AS CONSTRUCTED
Datum: WGTN2000 | Council Ref: RC6601 | Scale: 1:250m | Original Size: A1
Drawing Number: W16018-AB604 | Issue: 1

DO NOT SCALE DRAWING 0 1 2 3 4 5 6 7 8 9 10 11 12 13 14 15 16 17 18 19 20

DATE: 16 July 2019 12:41 PM
Reference Files: $?

Drawing File: P:\W16018\cad\W16018-01-AB600-WATER-01.dwg